



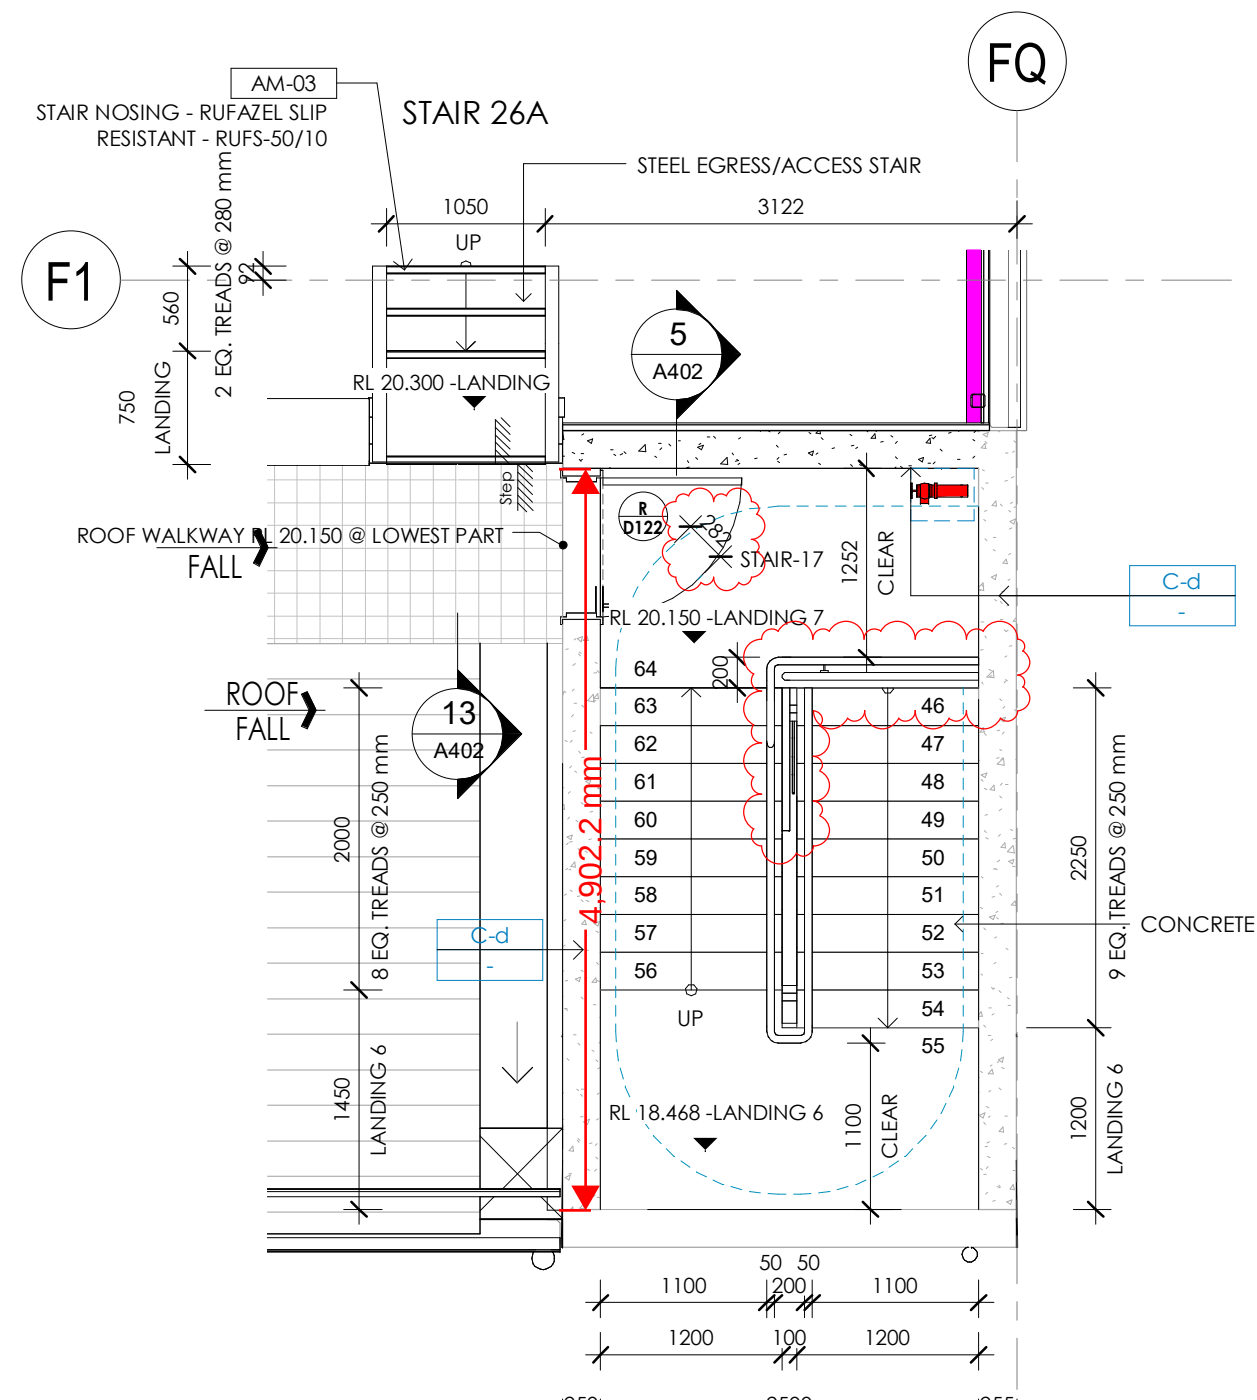


4 STAIR #17 - ROOF LEVEL
Scale: 1:50

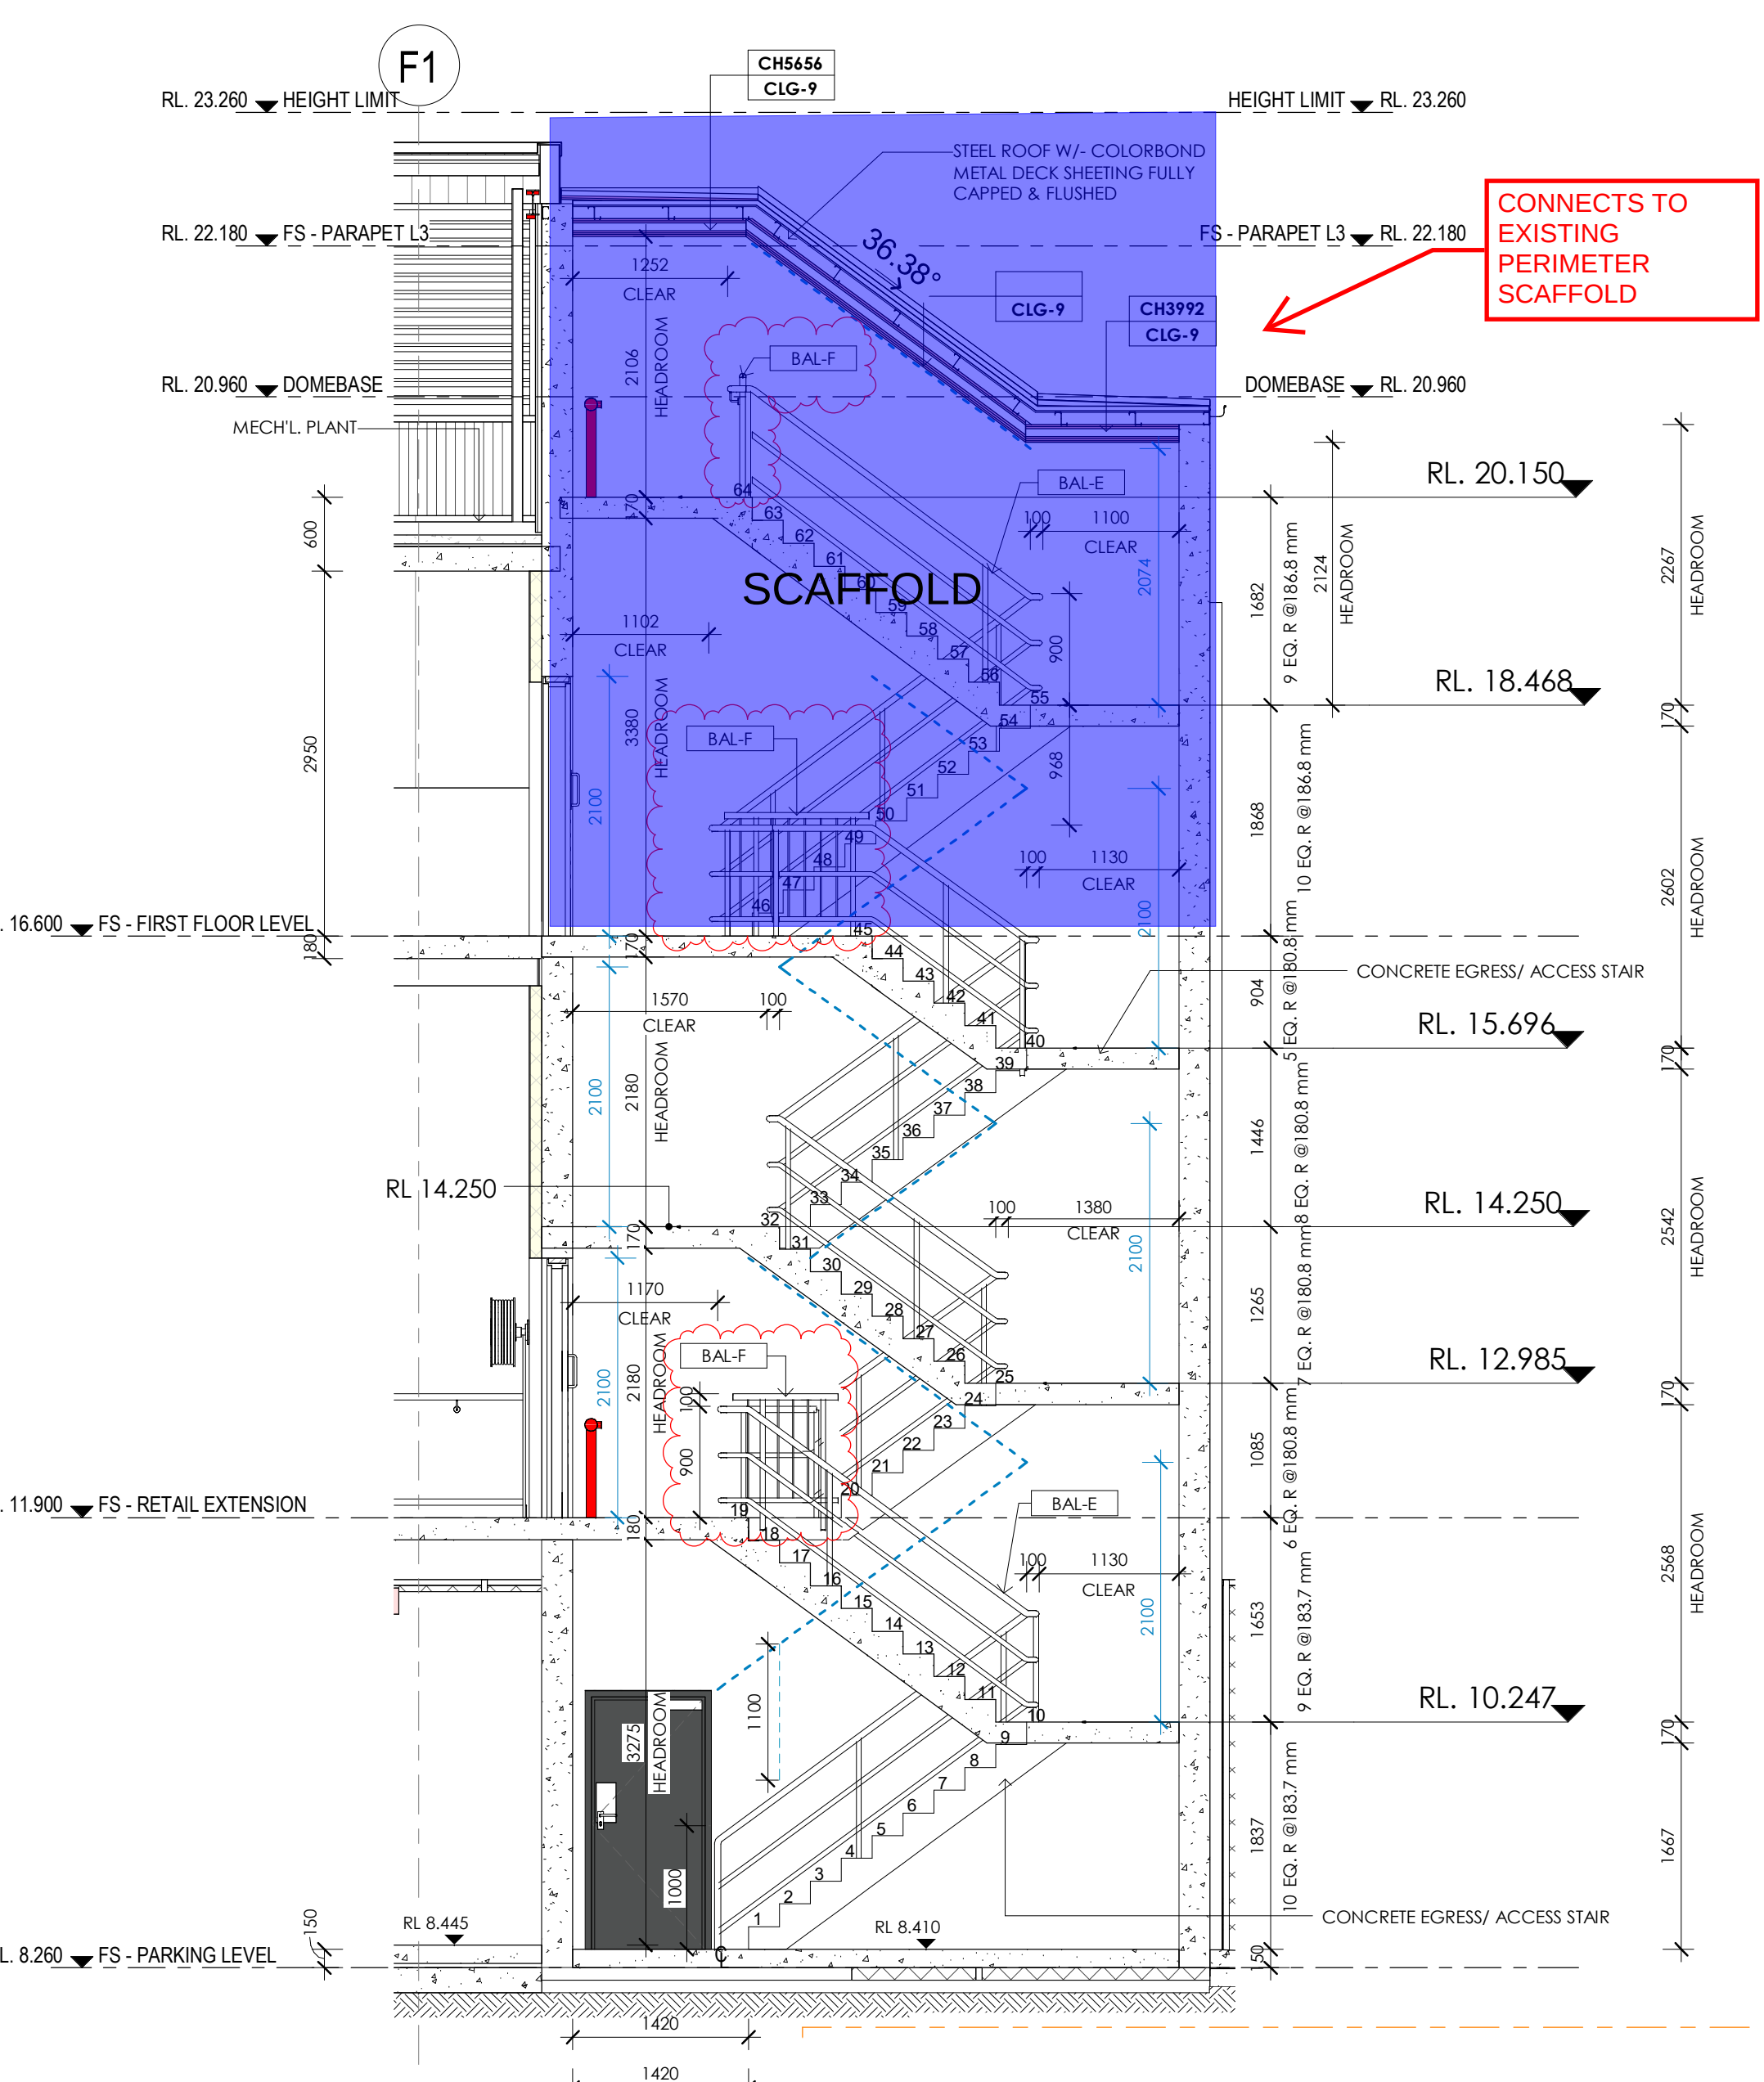


5 STAIR #17 - SECTION
Scale: 1:50

3 STAIR #17 - FIRST FLOOR
Scale: 1:50

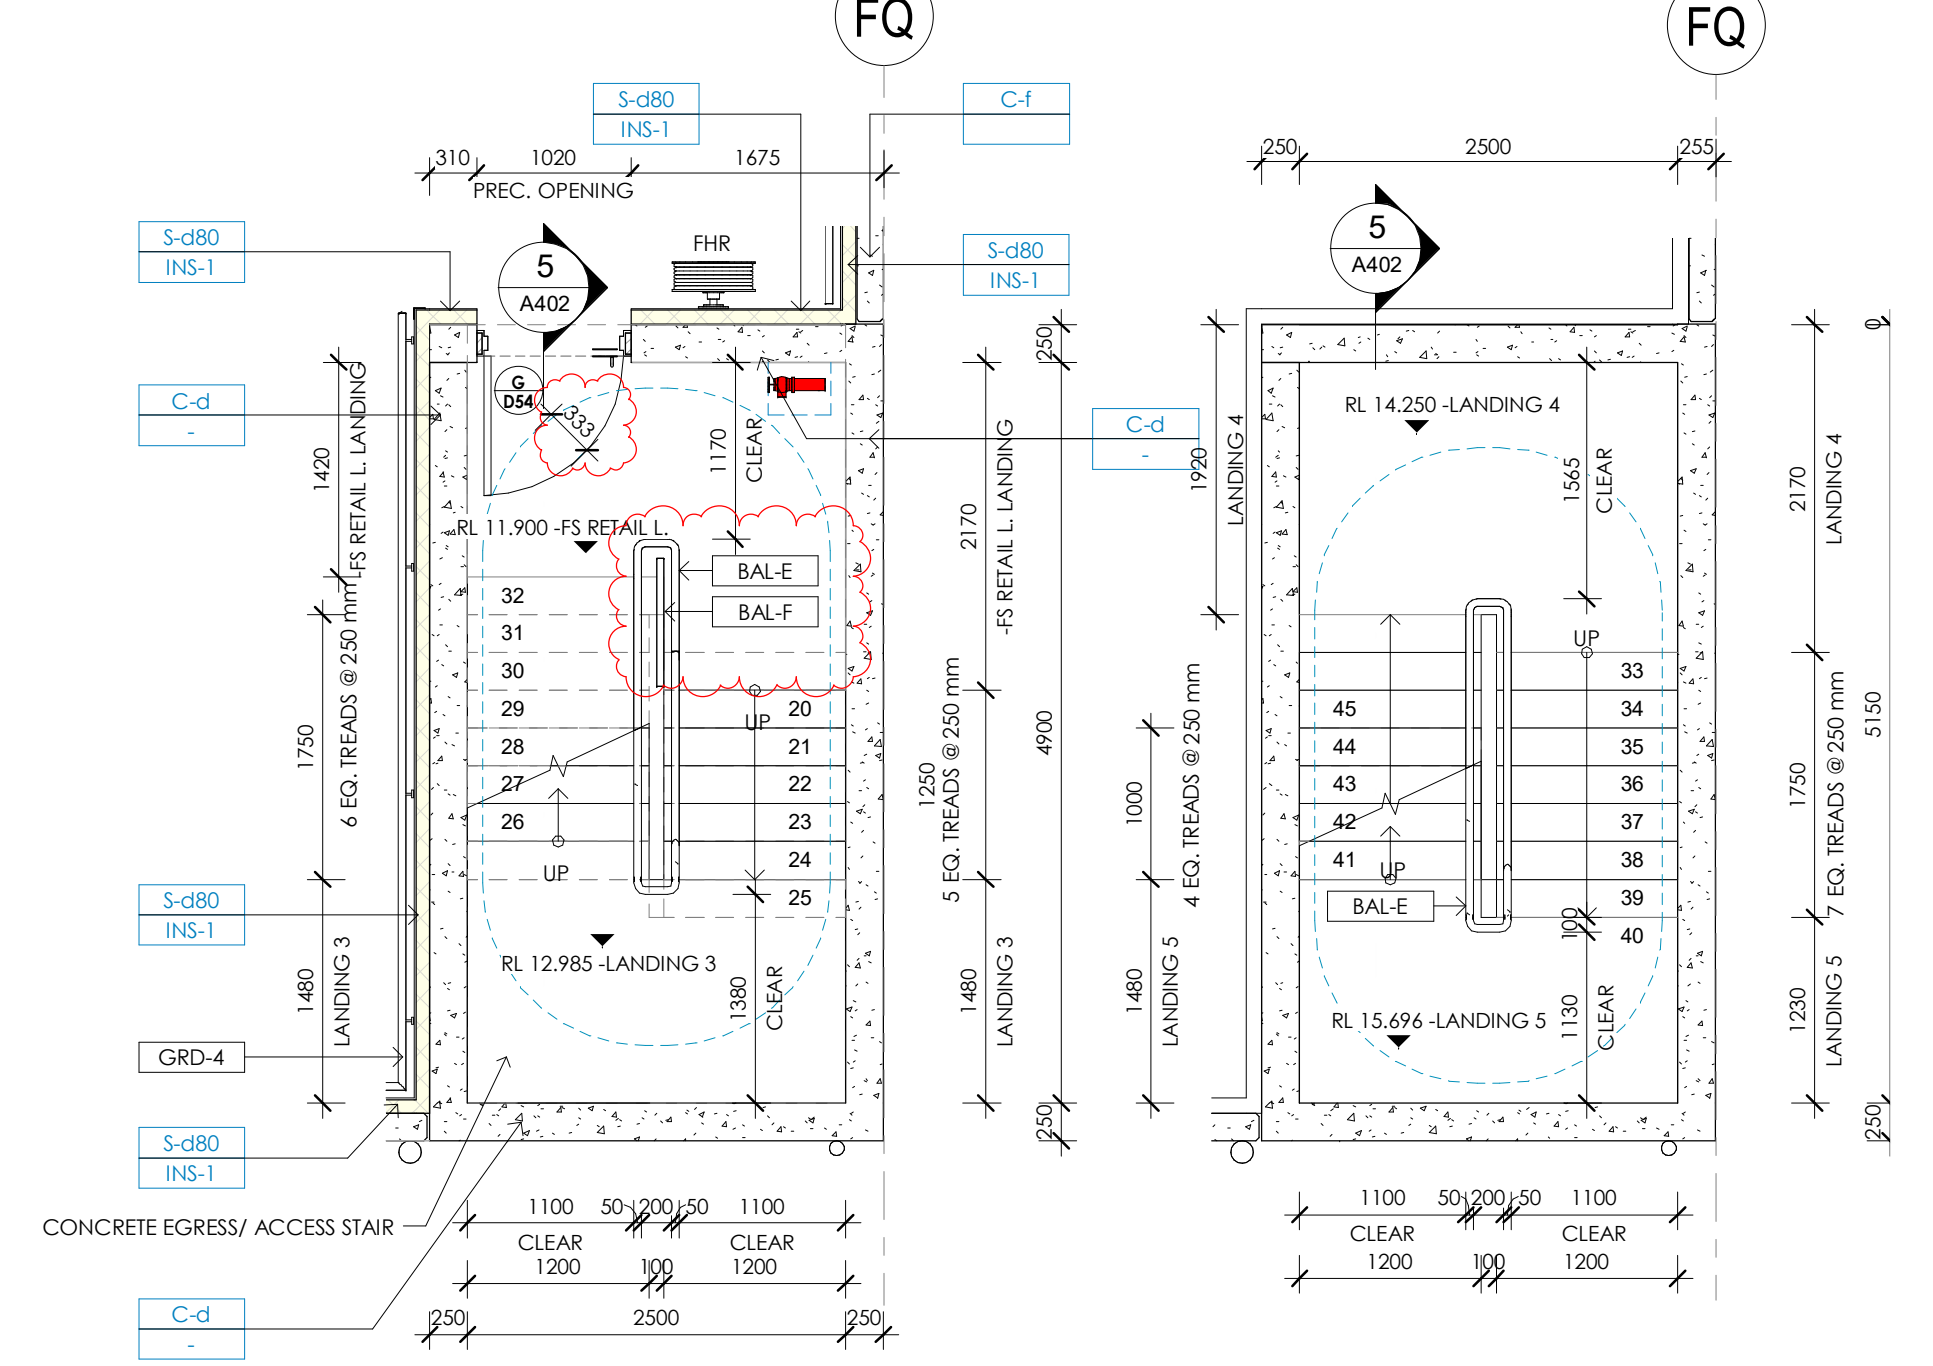


2 STAIR #17 - RETAIL LEVEL
Scale: 1:50

12 STAIR #17 LANDING - 4
Scale: 1:50

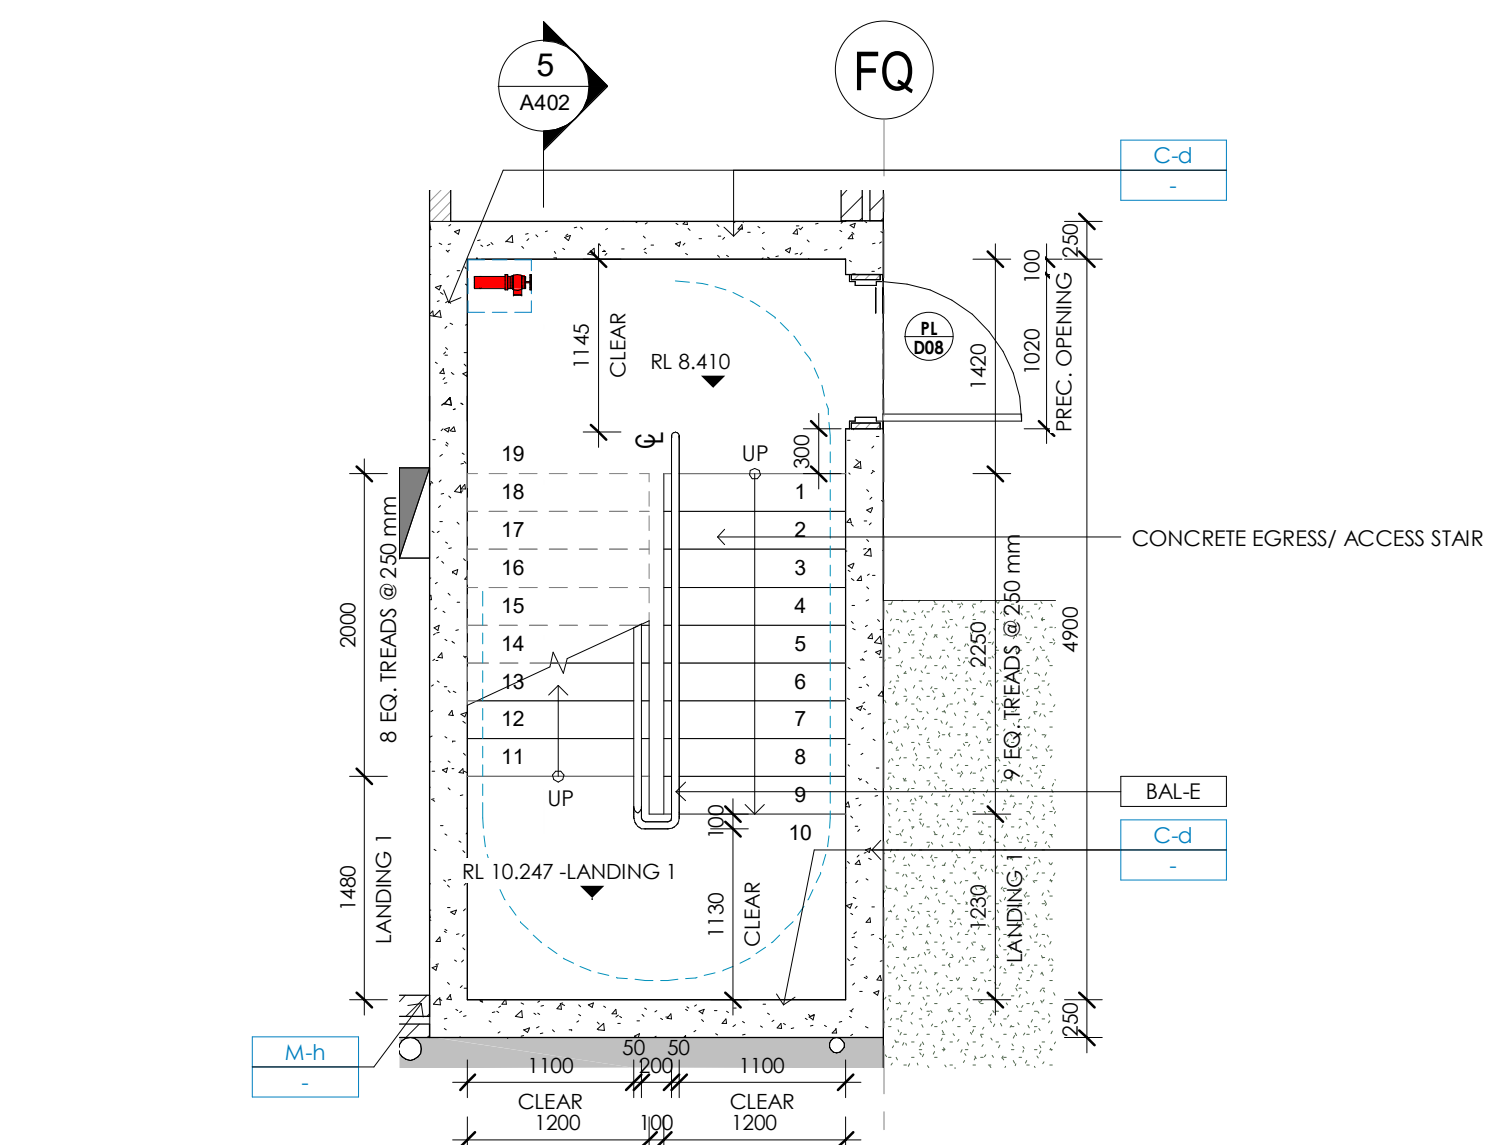

1 STAIR #17 - PARKING LEVEL
Scale: 1:50

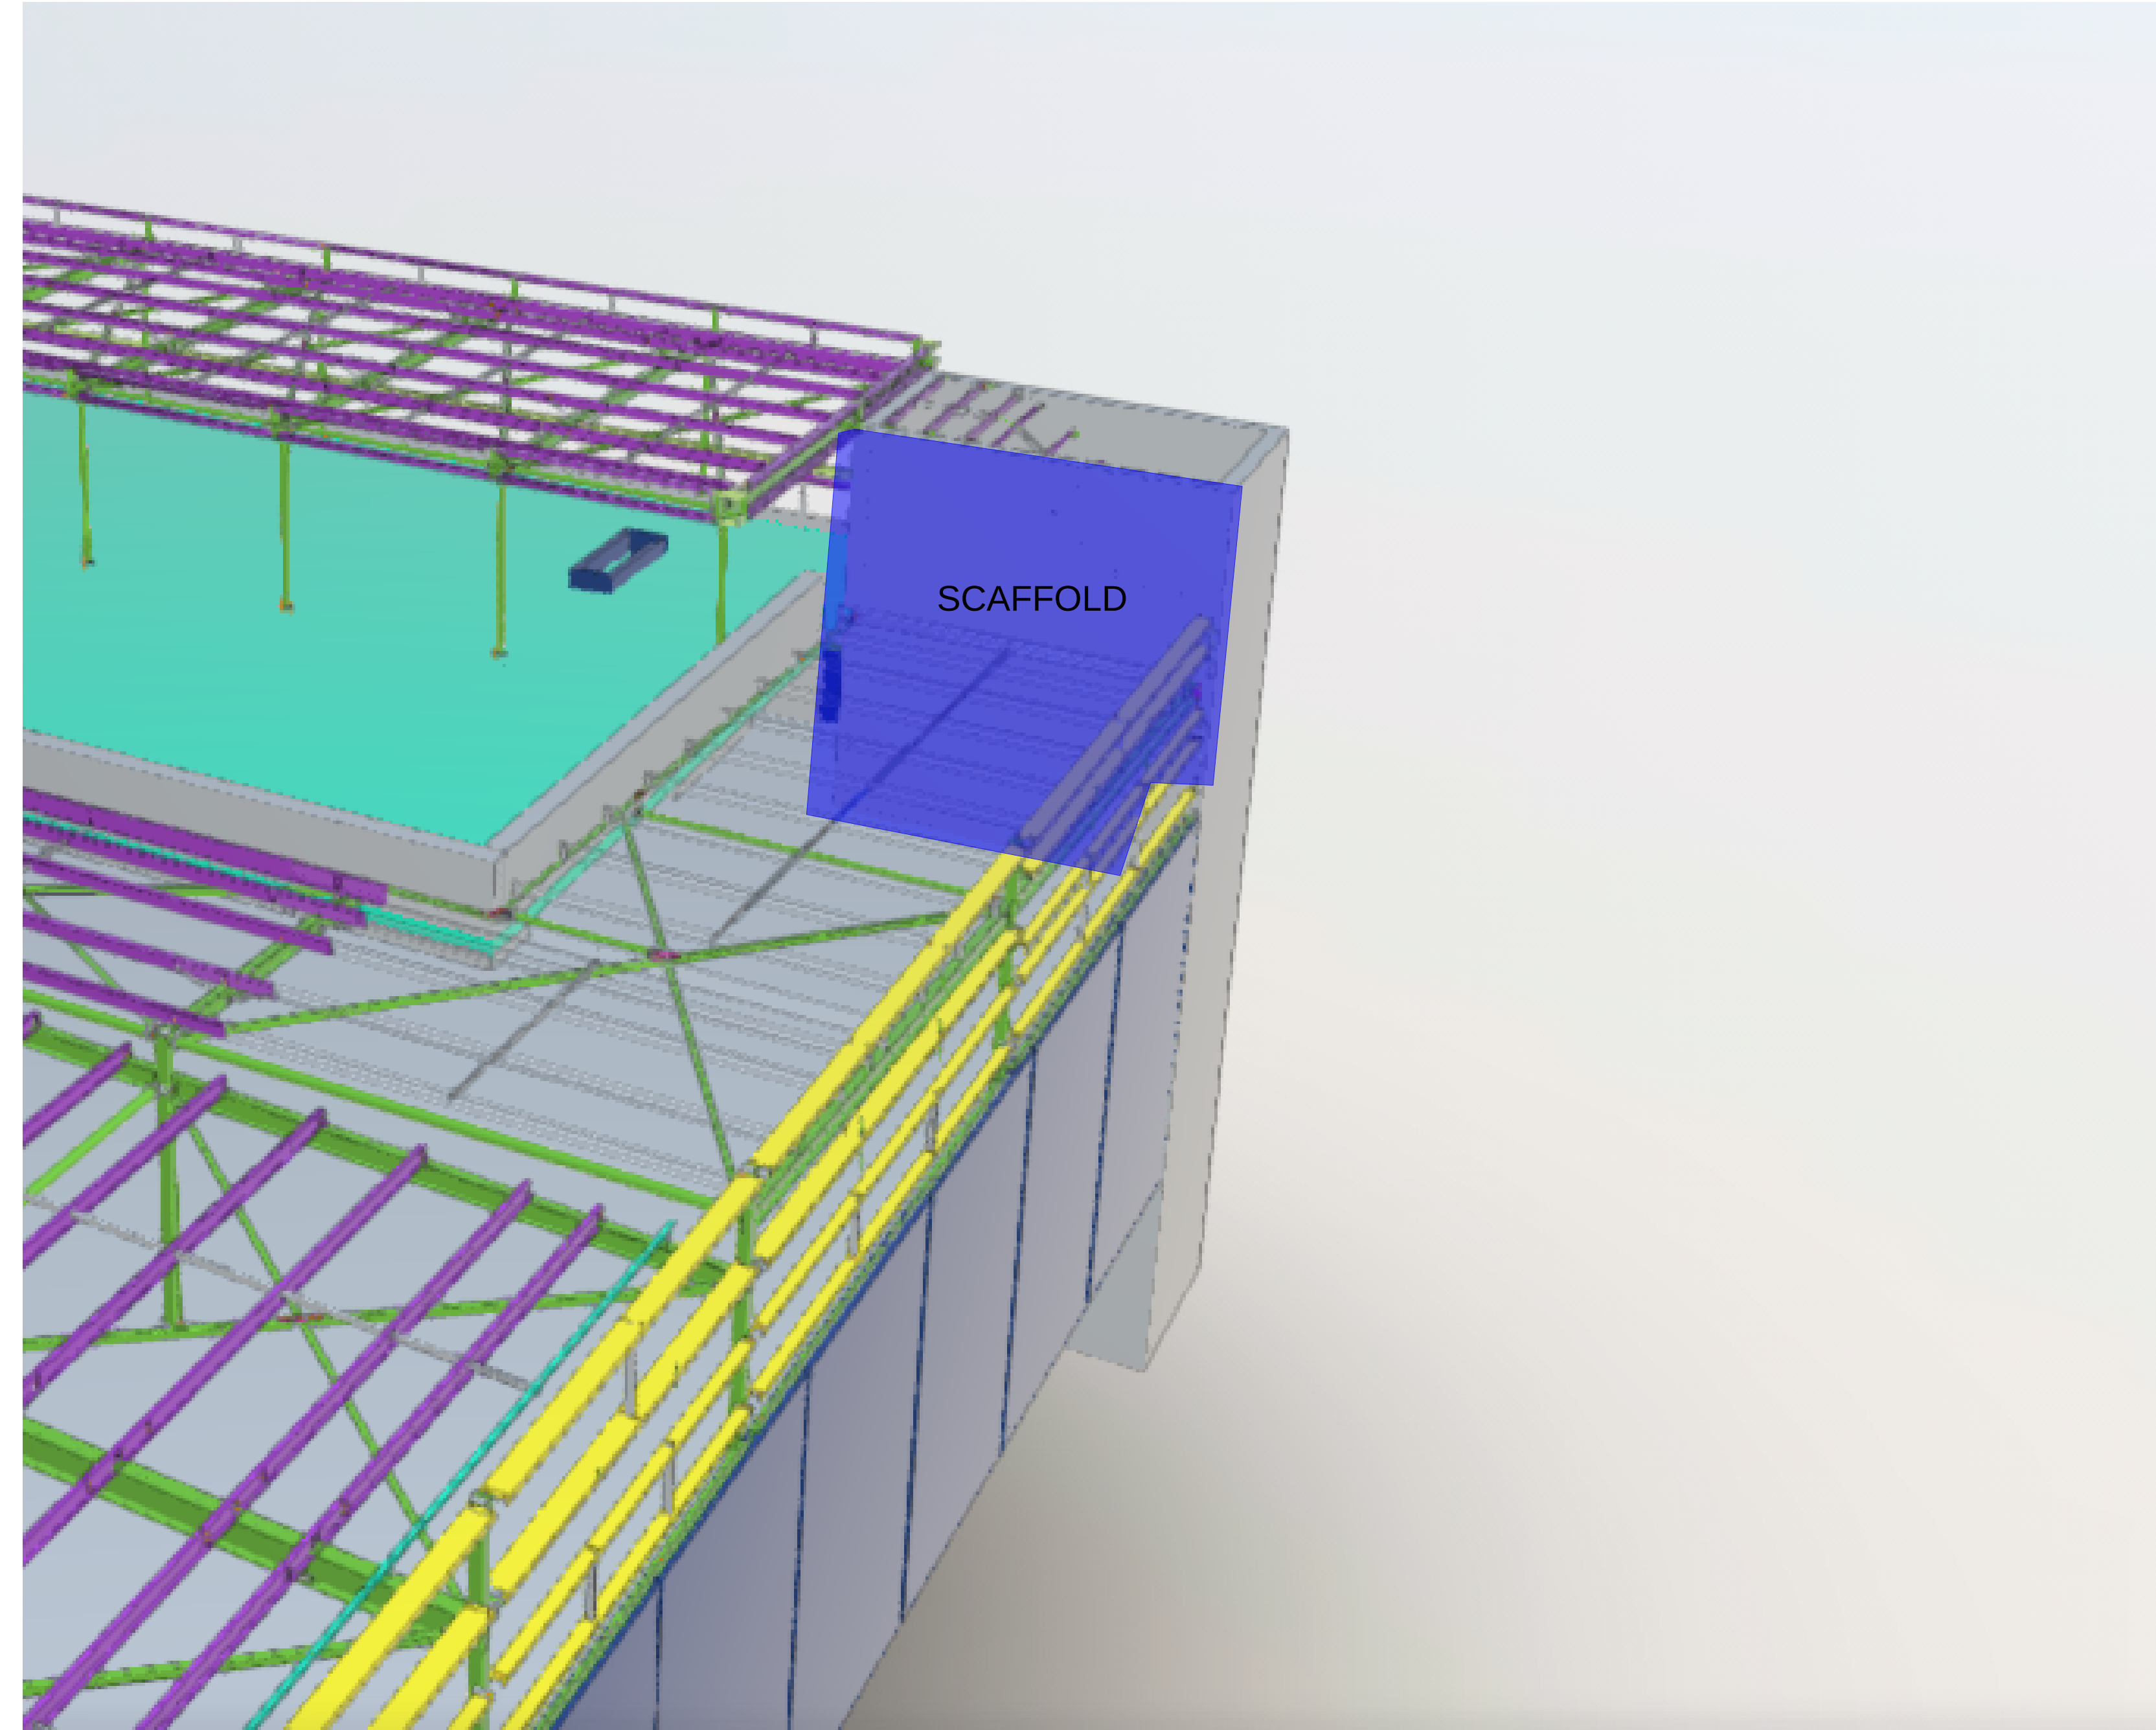

.. 20.700

.. 19.630

.. 18.026

.. 16.600

.. 15.284

.. 13.404

.. 592


ACCESS STAIR

EVEL RL 8.260

ISSUE	AMENDMENT	DATE	CHK'D
C	TENDER ADDENDUM	25-03-22	RG
D	REVISED TENDER ISSUE - (80%)	12-08-22	
E	REVISED TENDER ISSUE	30-06-23	
F	ISSUE FOR REVISED 80% TENDER	14-07-23	
G	ISSUE FOR REVISED 80% TENDER	25-09-23	
1	ISSUED FOR CONSTRUCTION	09/07/24	
2	DRAWING REVISED	22/07/24	SS
3	STAIR LANDING BARRIERS ADDED - HANDRAIL AND BARRIER HEIGHTS MODIFIED FOR COMPLIANCE. STAIR 14 LANDING RL CHANGED	23/08/24	

NOTE:
PROVIDE NOSING STRIPS FOR ALL STAIRS AS REQUIRED TO COMPLY WITH AUSTRALIAN STANDARDS.
AM-02 - NOSING STRIP FOR ALL CONCRETE STAIR
AM-03 - NOSING STRIP FOR ALL STEEL STAIR
REFER TO DRAWING SHEET No. A902 FOR SPECIFICATIONS/NOTES.
NO OPENING TO RISER IN STEEL STAIRS

- GENERAL NOTES - ALL DRAWINGS**
- ALL ARCHITECTURAL DRAWINGS SHALL BE READ IN CONJUNCTION WITH CURRENT ARCHITECTURAL SPECIFICATION, PPR AND ALL RELEVANT CONSULTANT DRAWINGS AND SPECIFICATIONS.
 - ORDER OF PRECEDENCE FOR DIMENSIONAL SETOUT, SPECIFICATIONS AND ARRANGEMENT OF FITOUT WORKS ARE AS FOLLOWS:
- SMALLER SCALE DRAWINGS AND DETAILS FOR FITMENT OF WORKS TAKE PRECEDENCE OVER LARGER SCALE GENERAL ARRANGEMENT DRAWINGS.
- WHERE AN ITEM IS NOMINATED BUT NOT NOTED, ANNOTATED OR SCHEDULED THEREIN IS TO CLARIFY ALL ITEMS.
- WHERE A CONFLICT ARISES BETWEEN A GENERAL ARRANGEMENT DRAWING AND A SMALLER SCALE DETAIL THE BUILDER IS TO CLARIFY THE DETAIL.
- WHERE A CONFLICT ARISES BETWEEN THE PPR, SPECIFICATION AND ARCHITECTURAL DRAWINGS THE CONTRACTOR IS TO CLARIFY THE DRAWINGS WITH A FORMAL RFI.
 - ALL FINALISED SERVICES AND FITOUT PENETRATIONS TO BE FULLY COORDINATED BY BUILDER. WHERE A CONFLICT ARISES BUILDER IS TO CONTACT THE SERVICES CONSULTANT FOR CLARIFICATION OF WORKS.
 - AT THE TIME OF ISSUE THIS DRAWING HAS BEEN PREPARED WITH ALL DUE CAUTION IN REGARD TO INCOMPLETE AND IMPROGRESS CONSULTANTS WORKS. BUILDERS ADVICE AND CLIENTS IN PROGRESS REVISIONS PLEASE NOTE AT TIME OF ISSUE DRAWINGS MAY NOT REFLECT THE LATEST CONSULTANTS WORKS. CONSULTANTS CHANGES BUILDERS ADVICE AND OF CLIENT DECISIONS NOT FORMALLY ISSUED BY BUILDER OR INCORPORATION INTO ARCHITECTURAL WORKS.

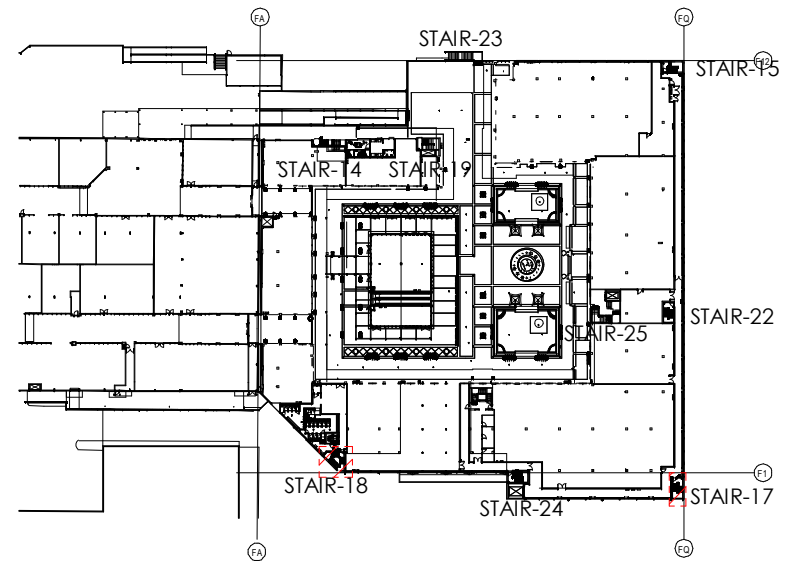

KEYPLAN

MARIOS SAVOPOULOS
ARCHITECT
THE PLACEMAKING STUDIO

CLIENT

GAZCORP PTY LTD

PROJECT
FASHION SPREE EXPANSION

5 VICO PLACE
LIVERPOOL, NSW 2170

DRAWING
STAIR DETAILS SHEET 2

DATE	SCALE @ A0	DRAWN
MAR 2021	As indicated	NY
PROJECT No.	DRAWING No.	ISSUE
4352	A402	3

SYDNEY	MELBOURNE	BRISBANE
7 Young St, Neutral Bay, NSW 2059 AUSTRALIA P +61 2 9109 3344 F +61 2 9109 3028 W www.saffermes.com.au	Level 2, 370 Lf Bourke St, VIC 3005 AUSTRALIA P +61 3 9554 6344 F +61 3 9554 6244 E saff@saftermes.com.au	15, 135/ 131 Lachlan St, QLD 4000 AUSTRALIA P +61 7 3123 5544 F +61 7 383 1860 E pr@saftermes.com.au

ADN 501 043 992 ADN 501 043 992

LEFFLER SIMES ARCHITECTS